


01 EAST ELEVATION
SCALE 100

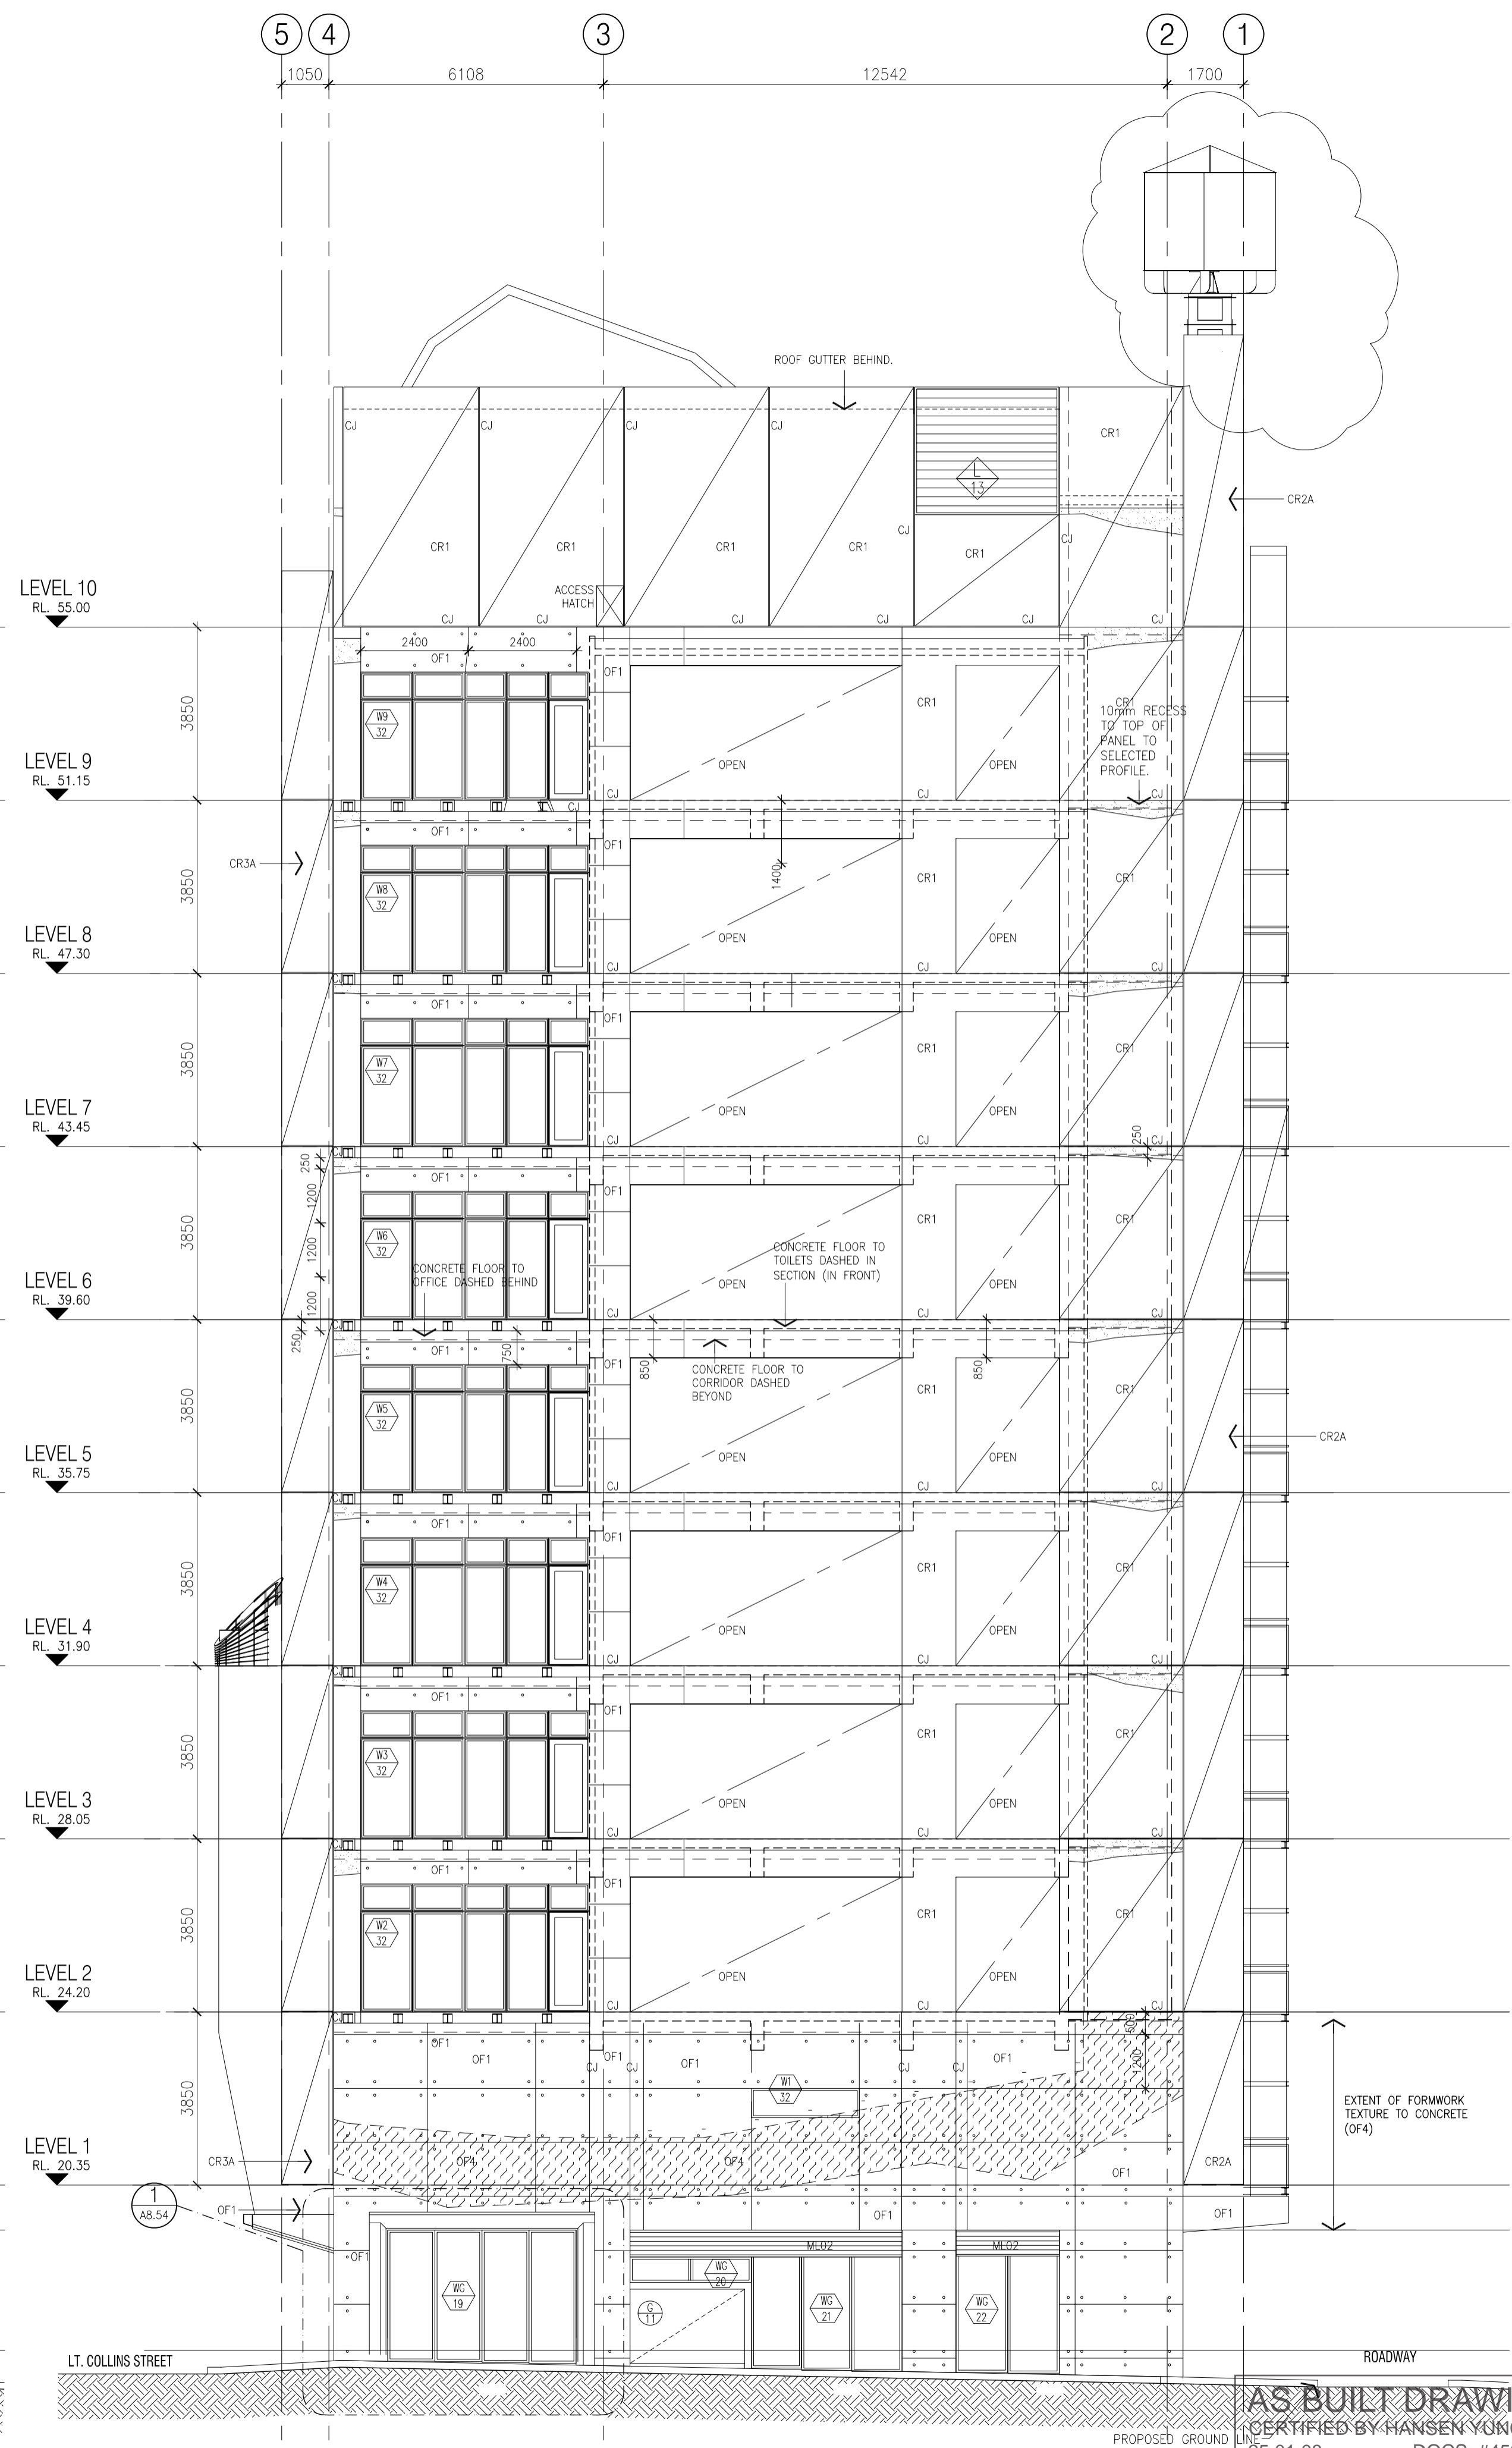

02 EAST ELEVATION - CONCRETE WALL ON GRID H
SCALE 100

AS BUILT DRAWING
CERTIFIED BY HANSEN YONCKEN
25.01.08 DOCS: #4526649

DO NOT SCALE - USE WRITTEN DIMENSIONS ONLY

C	20/12/05	BS issue, turbines updated	CT
B	15/08/05	AS NOTED	CT
A	10/08/04	RECESS TO PANEL EDGE & L10	CT
No	DATE	AMENDMENTS	AUTH.

SERVICES ENGINEERING
Lincolne Scott

CIVIL & STRUCTURAL ENGINEERING
Structural, Civil and Infrastructure Engineers
238 Punt Road Richmond 3121 Victoria Australia
Telephone 9429 8300 Facsimile 9429 5825
Email lincolne@lincolnegrp.com
Web Site www.lincolnegrp.com
ACN 069 332 345

PROJECT ARCHITECTS
DesignInc Melbourne Pty Ltd
in association with
City of Melbourne
City Projects Arts & Culture
Division

DesignInc Melbourne Pty Ltd ACN05544146
MELBOURNE CENTRAL TOWER
LEVEL 51 300 ELDRETH STREET MELBOURNE
VICTORIA 3000 AUSTRALIA
TELEPHONE +613 9654 9654 FACSIMILE +613 9654 4321
www.designinc.com.au EMAIL melbourne@designinc.com.au
Architecture Urban Design Interiors

Job No: 02072 Card No: A3.04

ARCHITECTURE & PROJECT MANAGEMENT
City Projects Arts and Culture Division
LEVEL 5 / 225 BOURKE STREET
MELBOURNE VIC 3000
TELEPHONE: (03) 9658 8693
FACSIMILE: (03) 9658 8840

CITY OF MELBOURNE
PROJECT
CH2
Tivoli Carpark Site Development
218-242 Little Collins Street
Melbourne

DRAWING
EAST ELEVATIONS

STATUS
CONSTRUCTION ISSUE
19.01.04

PASSED / REVIEWED	APPROVED / AUTH. FOR USE	
NORTH POINT	DESIGN SW/CT	DRAWN VT
	A1 SCALE 1:100	A3 SCALE 1:200
	DATE	
	JUL 03	
PROJ. NO. 901822	DWG. NO. A3.04	REV. C

© COPYRIGHT 2003 CITY OF MELBOURNE